


LOC	DIST	REVISIONS						
		P	LTR	DESCRIPTION	DATE	DWN	APVD	
J	-		A	REVISED	ECR-09-008889	01MAY09	TS	KB

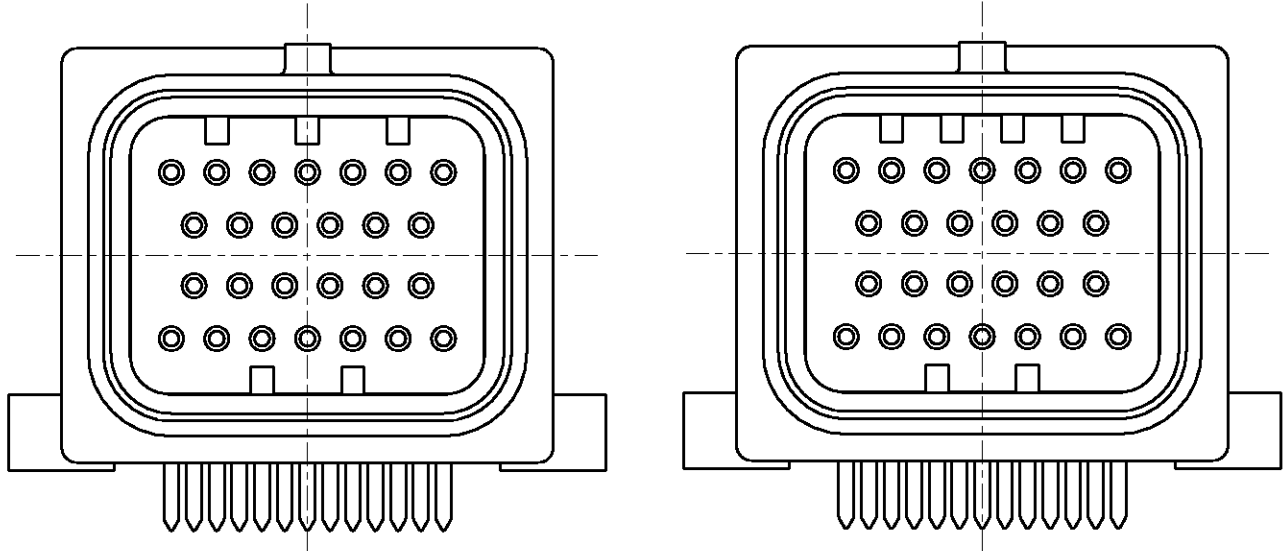

~~1473423-1~~
6473423-1

~~1473423-2~~
6473423-2

- SEE 9-1437287-8 FOR OTHER FEATURES
- PART NUMBER OF PLUG ASSEMBLY TO BE MATED: SEE TABLE-1

- その他の形状は、9-1437287-8参照。
- 嵌合相手型番：TABLE-1参照。

6473423-2	1473416-2
1473423-2	
6473423-1	1473416-1
1473423-1	
PART NUMBER	MATING PLUG ASSEMBLY

TABLE-1

RELEASED FOR PUBLICATION 20

THIS DRAWING IS UNPUBLISHED. BY TYCO ELECTRONICS CORPORATION. ALL RIGHTS RESERVED. COPYRIGHT 20

DIMENSIONS: 単位: 毫 mm		DWN S. FURUYA 05APR01	WIRE RANGE 挿合電線断面積	INSULATION DIA 被覆外径
TOLERANCES UNLESS OTHERWISE SPECIFIED:		CHK Y. FUJIWARA 05APR01	MATERIAL	FINISH 仕上
0 PLC ±		APVD K. ASAI 05APR01	Tyco Electronics Corporation Kawasaki, Japan	
1 PLC ±0.5		PRODUCT SPEC 製品規格		
2 PLC ±0.13		APPLICATION SPEC 取付適用規格	SUPER SEAL CONN. (UPPER LOCK TYPE) CAP HOUSING 26Pos. ASSEMBLY	
3 PLC ±0.013		WEIGHT	SIZE	CAGE CODE
4 PLC ±0.0001			A4	
ANGLES ±1°00'			DRAWING NO 番号	RESTRICTED TO
			C=1473423	-
CUSTOMER DRAWING			SCALE 尺度	SHEET 1 OF 1
			2:1	REV A