


| P | LTR | DESCRIPTION                           | DATE      | DWN | APVD |
|---|-----|---------------------------------------|-----------|-----|------|
|   | B   | RESIN SUPPLIER CHANGE FOR THE HOUSING | 30MAY2022 | SCB | PS   |
|   | B1  | PART OBSOLESCENCE                     | 19DEC2024 | RS  | VG   |
|   |     |                                       |           |     |      |
|   |     |                                       |           |     |      |

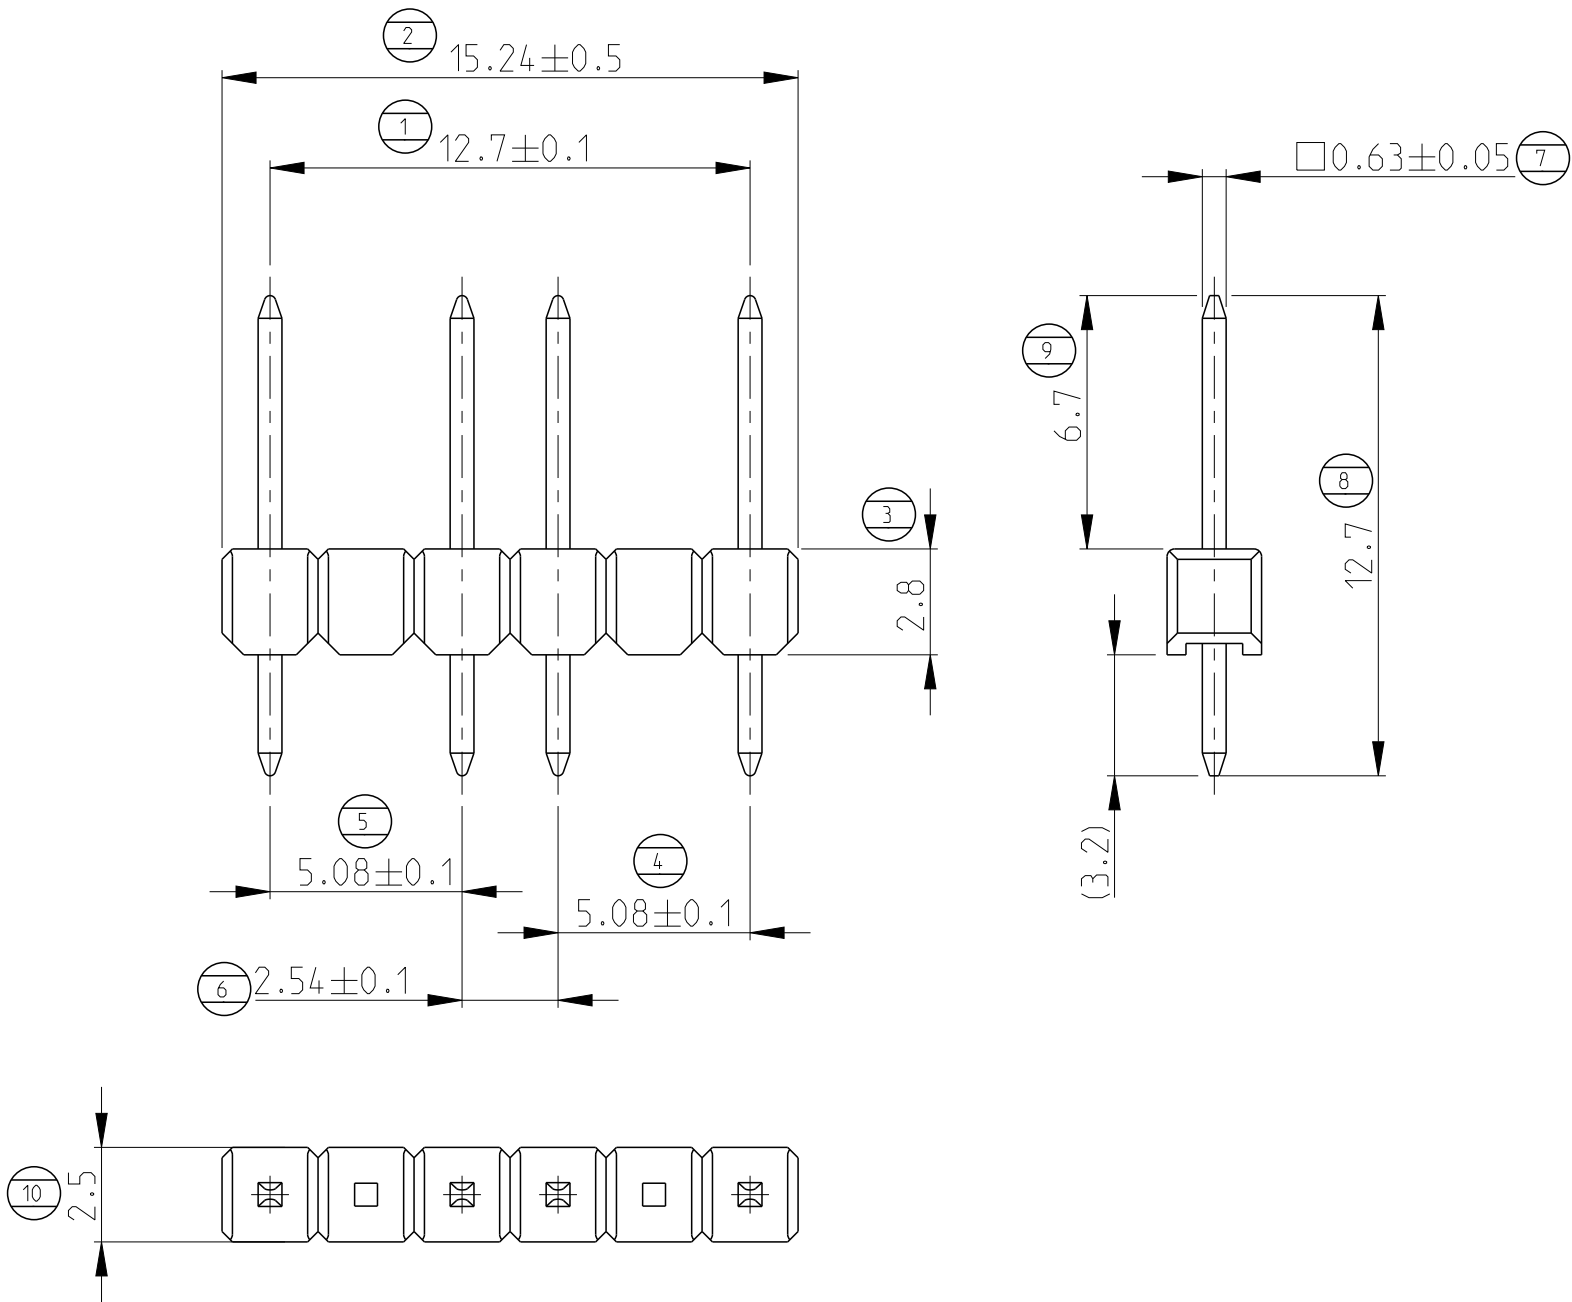




3 ~~1 AS SHOWN~~  
~~WIE GEZEICHNET~~

- 1 PIN TIPS PARTIALLY UNPLATED
- 2 SIMILAR TO PART 826926-6
- 3 OBSOLETE

|                                        |          |                              |
|----------------------------------------|----------|------------------------------|
| MIN. 2 µm TIN<br>OVER 1.27 µm NICKEL 1 | CuSn     | CONTACT PIN<br>KONTAKTSTIFT  |
| COLOUR, GREEN                          | PBT GV   | PIN HOUSING<br>STIFTGEHAEUSE |
| SURFACE/COLOUR                         | MATERIAL | DESCRIPTION<br>BEZEICHNUNG   |

|                                        |                                                                              |                                     |                                                                                  |                 |                            |
|----------------------------------------|------------------------------------------------------------------------------|-------------------------------------|----------------------------------------------------------------------------------|-----------------|----------------------------|
| THIS DRAWING IS A CONTROLLED DOCUMENT. |                                                                              | DWN<br>G.ACKERMANN<br>12JAN2006     | TE Connectivity                                                                  |                 |                            |
|                                        |                                                                              | CHK<br>M.SCHAARSCHMIDT<br>12JAN2006 |                                                                                  |                 |                            |
| DIMENSIONS:<br>mm                      | TOLERANCES UNLESS<br>OTHERWISE SPECIFIED:                                    | APVD<br>G.FELDMEIER                 | NAME<br>AMPMODU II<br>PIN HEADER RANDOM LOADED<br>STIFTELEISTE SONDERBESTUECKUNG |                 |                            |
|                                        |                                                                              | PRODUCT SPEC                        |                                                                                  |                 |                            |
|                                        | 0 PLC ±0.2<br>1 PLC ±0.2<br>2 PLC ±0.2<br>3 PLC ±-<br>4 PLC ±-<br>ANGLES ±2° | APPLICATION SPEC                    | SIZE<br>A3                                                                       |                 |                            |
|                                        |                                                                              | WEIGHT                              |                                                                                  |                 |                            |
| MATERIAL                               | FINISH                                                                       | CUSTOMER DRAWING                    | SCALE<br>5:1                                                                     | SHEET<br>1 OF 3 | RESTRICTED TO<br>REV<br>B1 |


| P | LTR | DESCRIPTION | DATE | DWN | APVD |
|---|-----|-------------|------|-----|------|
|   | -   | SEE SHEET 1 | -    | -   | -    |
|   |     |             |      |     |      |
|   |     |             |      |     |      |
|   |     |             |      |     |      |

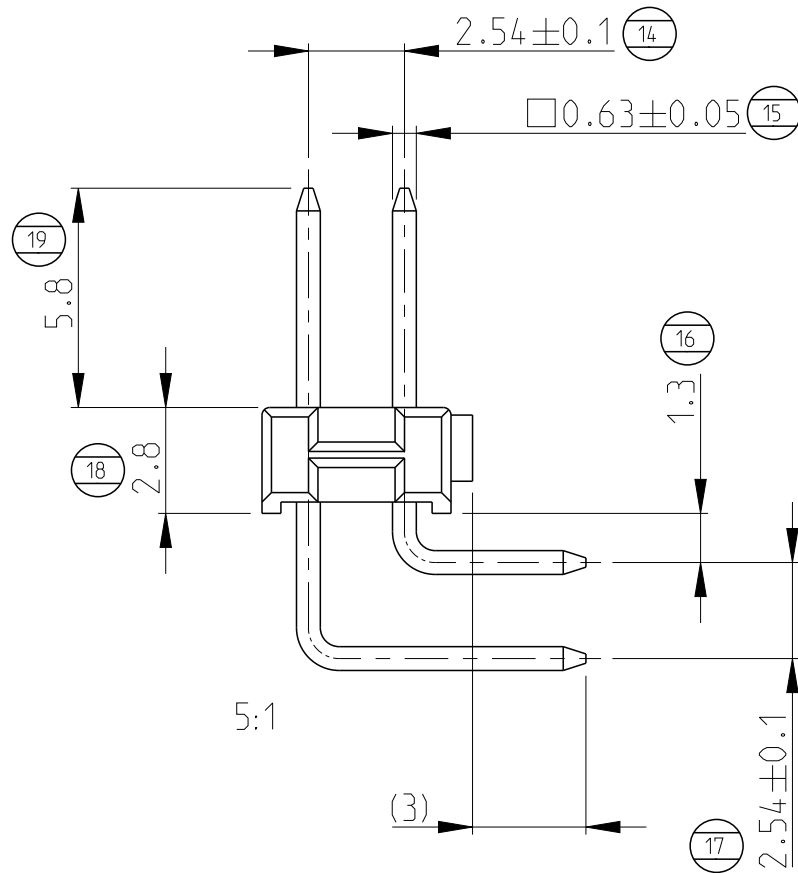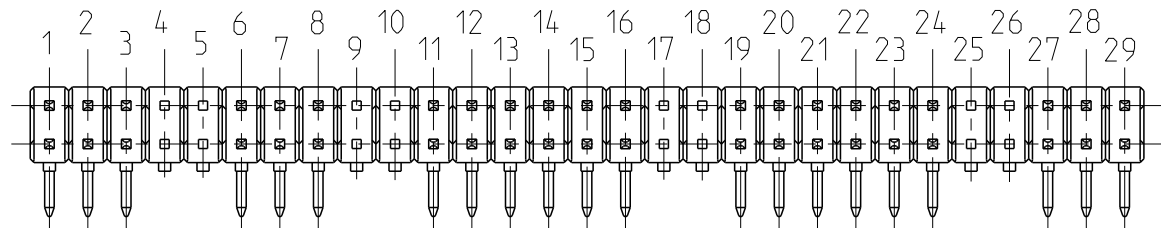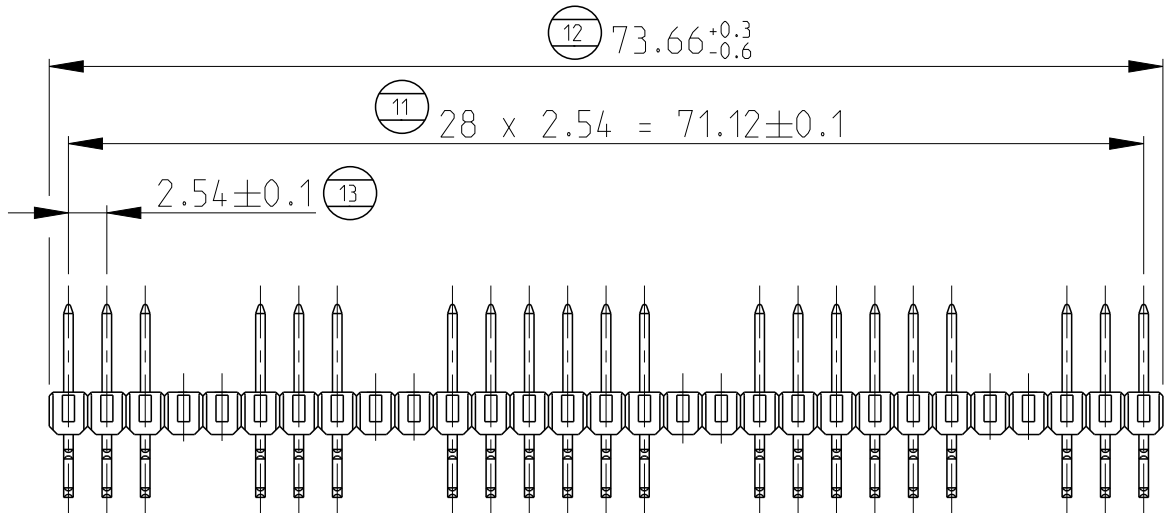




3 ~~2 AS SHOWN~~  
~~WIE GEZEICHNET~~

- 1 PIN TIPS PARTIALLY UNPLATED
- 2 SIMILAR TO PART 2-826955-9
- 3 OBSOLETE

|                                        |          |                              |
|----------------------------------------|----------|------------------------------|
| MIN. 2 µm TIN<br>OVER 1.27 µm NICKEL 1 | CuSn     | CONTACT PIN<br>KONTAKTSTIFT  |
| COLOUR GREEN                           | PBT GV   | PIN HOUSING<br>STIFTGEHAEUSE |
| SURFACE / COLOUR                       | MATERIAL | DESCRIPTION<br>BEZEICHNUNG   |

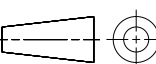
|                                                                                       |                                                                            |                                     |                                                                                                       |                                                                                  |                    |                         |                        |
|---------------------------------------------------------------------------------------|----------------------------------------------------------------------------|-------------------------------------|-------------------------------------------------------------------------------------------------------|----------------------------------------------------------------------------------|--------------------|-------------------------|------------------------|
| THIS DRAWING IS A CONTROLLED DOCUMENT.                                                |                                                                            | DWN<br>G.ACKERMANN<br>12JAN2006     |  TE Connectivity |                                                                                  |                    |                         |                        |
|                                                                                       |                                                                            | CHK<br>M.SCHAARSCHMIDT<br>12JAN2006 |                                                                                                       |                                                                                  |                    |                         |                        |
| DIMENSIONS:<br><br>mm                                                                 | TOLERANCES UNLESS<br>OTHERWISE SPECIFIED:                                  |                                     | APVD<br>G.FELDMEIER<br>-                                                                              | NAME<br>AMPMODU II<br>PIN HEADER RANDOM LOADED<br>STIFTELEISTE SONDERBESTUECKUNG |                    |                         |                        |
|  | 0 PLC ±0.2<br>1 PLC ±0.2<br>2 PLC ±0.2<br>3 PLC ±<br>4 PLC ±<br>ANGLES ±2° |                                     | PRODUCT SPEC<br><br>-                                                                                 |                                                                                  |                    |                         |                        |
|                                                                                       |                                                                            |                                     | APPLICATION SPEC<br><br>-                                                                             |                                                                                  |                    |                         |                        |
|                                                                                       |                                                                            |                                     | WEIGHT<br>-                                                                                           |                                                                                  |                    |                         |                        |
|                                                                                       |                                                                            |                                     |                                                                                                       |                                                                                  |                    |                         |                        |
| MATERIAL<br><br>-                                                                     | FINISH<br><br>-                                                            |                                     | SIZE<br>A3                                                                                            |                                                                                  | CAGE CODE<br>00779 | DRAWING NO<br>C=1740624 | RESTRICTED TO<br><br>- |
| CUSTOMER DRAWING                                                                      |                                                                            |                                     | SCALE<br>2:1                                                                                          |                                                                                  | SHEET<br>2 OF 3    | REV<br>B1               |                        |

| P | LTR | DESCRIPTION | DATE | DWN | APVD |
|---|-----|-------------|------|-----|------|
|   | -   | SEE SHEET 1 | -    | -   | -    |
|   |     |             |      |     |      |
|   |     |             |      |     |      |
|   |     |             |      |     |      |

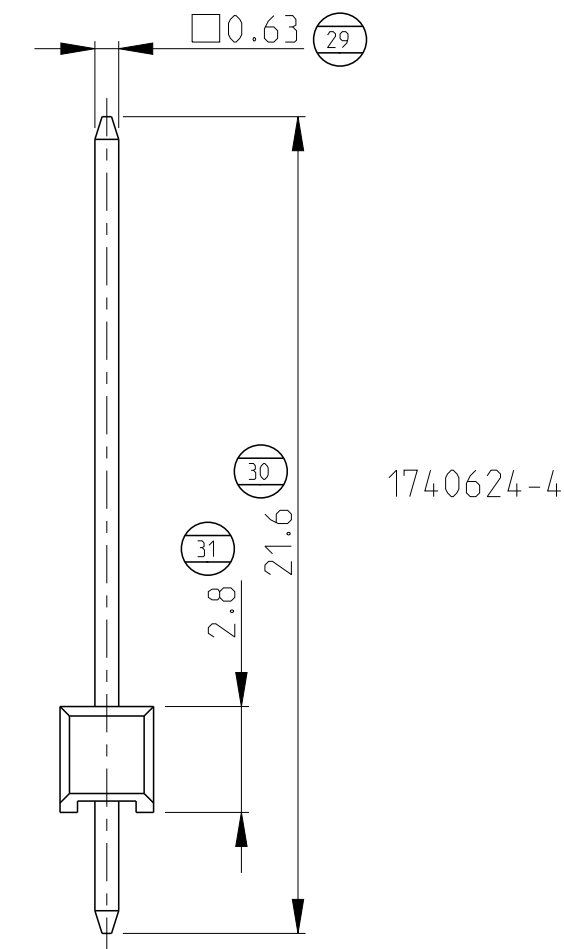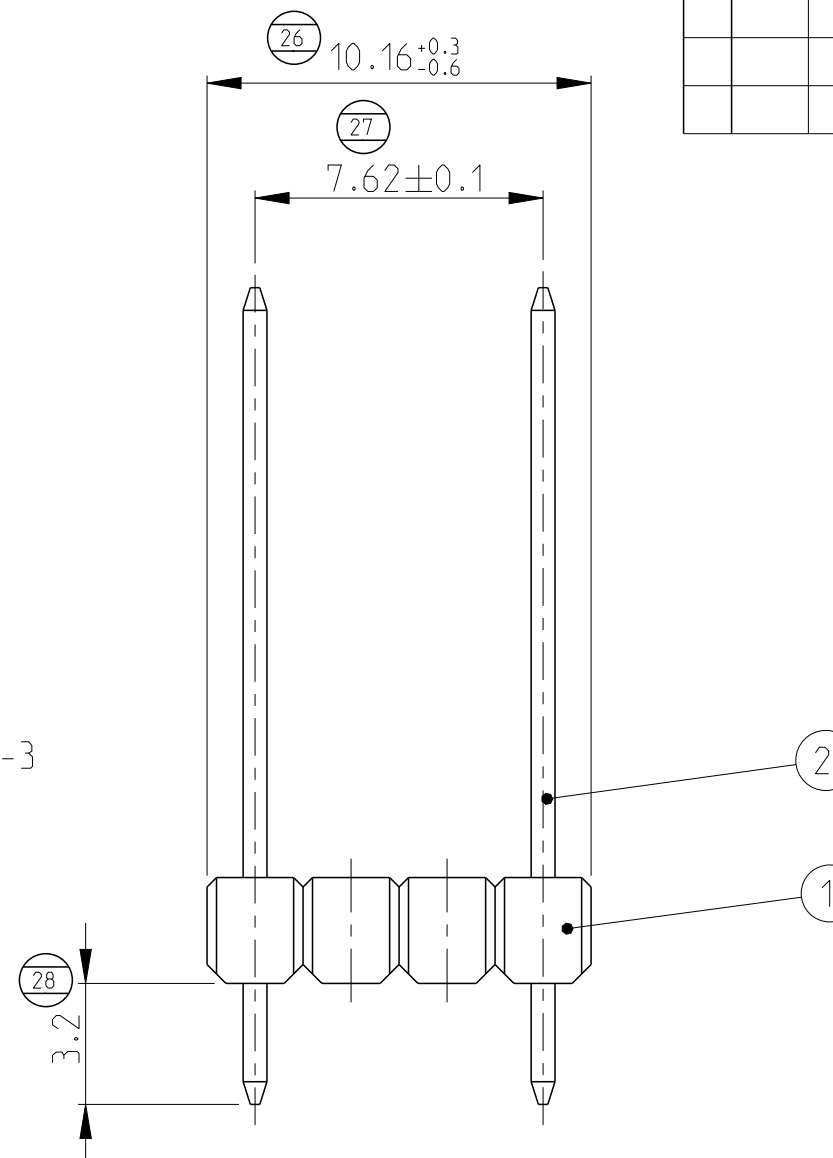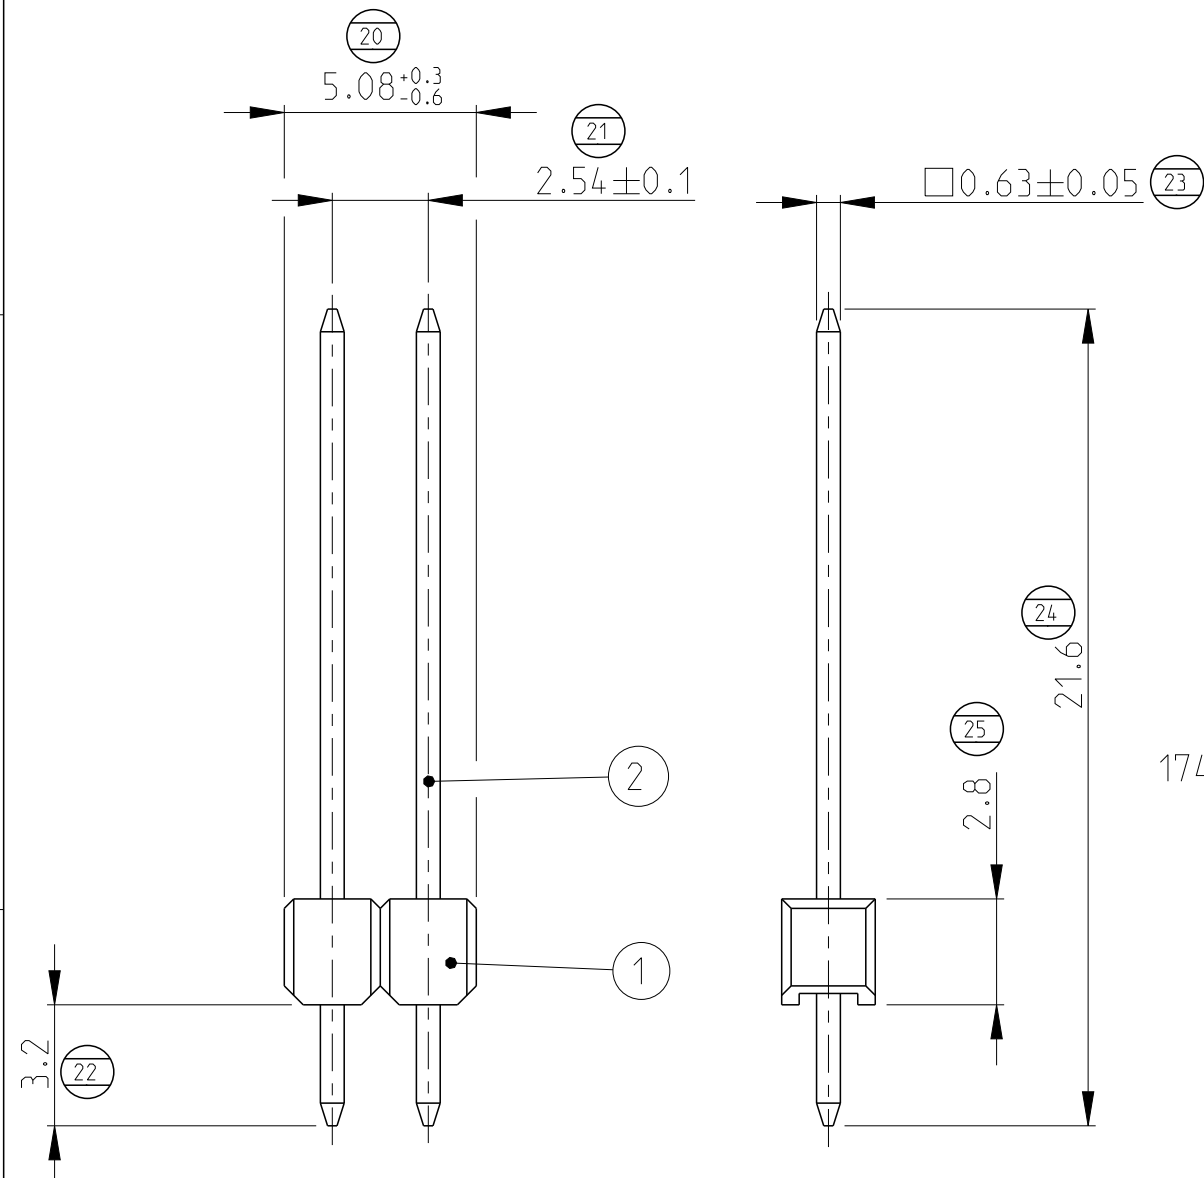

- |                                                                                     |                                                        |
|-------------------------------------------------------------------------------------|--------------------------------------------------------|
| 1                                                                                   | PIN TIPS PARTIALLY WITHOUT SURFACE                     |
|  | PRE-TIN PLATED                                         |
| 3                                                                                   | RECOMMENDED PCB HOLE DIAMETER $\varnothing 1 \pm 0.05$ |

|                                                                                                       |                              |          |                  |
|-------------------------------------------------------------------------------------------------------|------------------------------|----------|------------------|
| TIN OVER NICKEL  | CONTACT PIN<br>KONTAKTSTIFT  | CuSn     | 2                |
| COLOUR BLACK                                                                                          | PIN HOUSING<br>STIFTGEHAEUSE | PCT GV   | 1                |
| REMARK                                                                                                | DESCRIPTION<br>BEZEICHNUNG   | MATERIAL | ITEM<br>LFD. NR. |
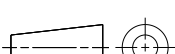
|                                                                                       |  |                                                                                                                                     |  |                                                                                 |  |                                                                                                       |  |           |  |
|---------------------------------------------------------------------------------------|--|-------------------------------------------------------------------------------------------------------------------------------------|--|---------------------------------------------------------------------------------|--|-------------------------------------------------------------------------------------------------------|--|-----------|--|
| THIS DRAWING IS A CONTROLLED DOCUMENT.                                                |  | DWN<br>G.ACKERMANN<br>CHK<br>M.SCHAARSCHMIDT<br>APVD<br>G.FELDMEIER<br>PRODUCT SPEC<br>-<br>APPLICATION SPEC<br>-<br>WEIGHT<br>-    |  | 12 JAN 2006<br>12 JAN 2006                                                      |  |  TE Connectivity |  |           |  |
| DIMENSIONS:<br>mm                                                                     |  | <div><div>0 PLC ±0.2</div><div>1 PLC ±0.2</div><div>2 PLC ±0.2</div><div>3 PLC ±</div><div>4 PLC ±</div><div>ANGLES ±2°</div></div> |  | NAME<br>AMP MODU II<br>PIN HEADER RANDOM LOADED<br>STIFTLISTE SONDERBESTUECKUNG |  | SIZE<br>A 3<br>CAGE CODE<br>00779<br>DRAWING NO<br>C=1740624<br>RESTRICTED TO<br>-                    |  |           |  |
|  |  |                                                                                                                                     |  |                                                                                 |  |                                                                                                       |  |           |  |
| MATERIAL<br>-                                                                         |  |                                                                                                                                     |  |                                                                                 |  |                                                                                                       |  |           |  |
| FINISH<br>-                                                                           |  |                                                                                                                                     |  |                                                                                 |  |                                                                                                       |  |           |  |
| CUSTOMER DRAWING                                                                      |  |                                                                                                                                     |  | SCALE<br>5:1                                                                    |  | SHEET<br>3 OF 3                                                                                       |  | REV<br>B1 |  |