

PROJEKT NR.:		REVISIONS				
PRJ-17-906848		ÄNDERUNGEN				
P	LTR	DESCRIPTION BESCHREIBUNG	DATE	DWN	APVD	
	A	NEW DRAWING	26 JUL 2018	CS	JB	
	A1	Appl. and Prod. Spec. added	27 JUL 2020	KS	JB	
	A2	As per PCN-23-189755	15 OCT 2023	ARD	W J	

NOTES
Bemerkungen

- A2

1




~~TE ORDER NUMBER AND REVISION~~
~~TE Bestell-Nummer und Revision~~
- A2

2

~~MOLD CAVITY MARKING~~
~~Nestmarkierung~~
- 3

FOR INSULATION DIAMETER 3.1-4.2mm

Für Isolationsdurchmesser 3.1-4.2mm

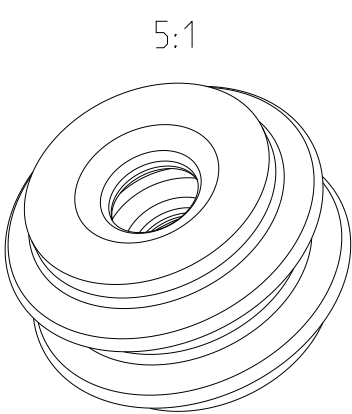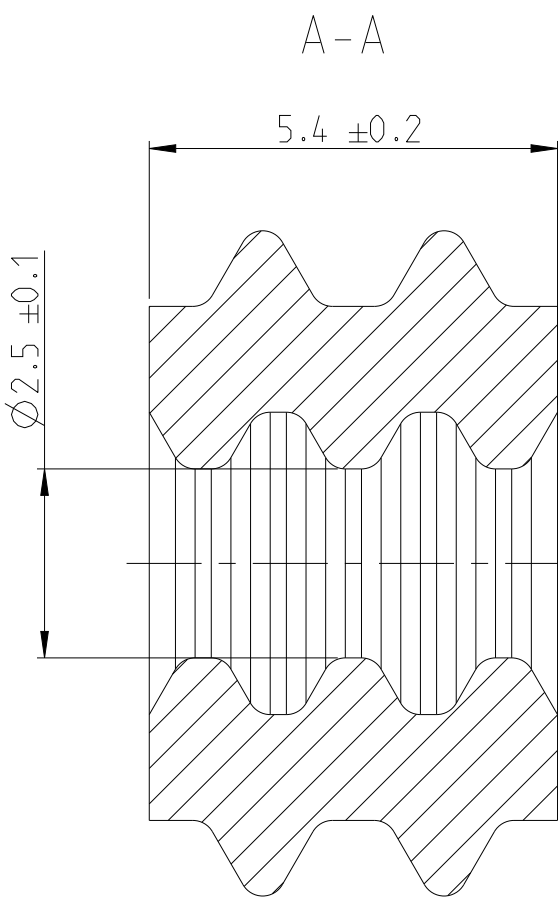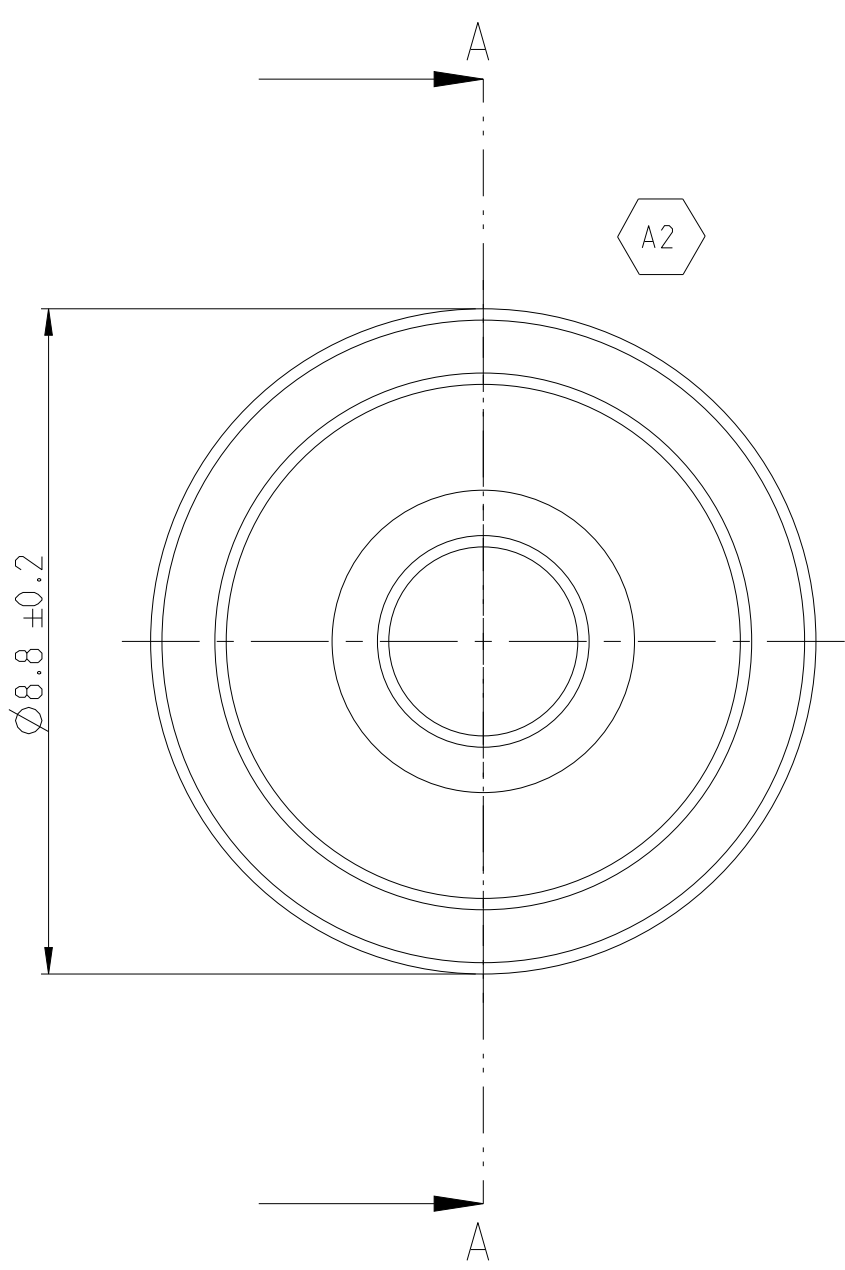

DIMENSION AND TOLERANCES ACCORDING TO:
Bemaßungen und Toleranzen gemäß:

DIN 3302-1 M1
DIN 3302-1 M2

DIN EN ISO 8015 **AD** - DIN EN ISO 291
DIN EN ISO 14405

9-2334941-1	A	1	SILICON SHORE 50	GREEN gruen	HD MATenet 1+6 SWS. GRP D	1
TE ORDER-NO. TE Bestell-Nr.	REV.	QTY Anzahl	MATERIAL	COLOUR Farbe	DESCRIPTION Beschreibung	ITEM

A2

THIS DRAWING IS A CONTROLLED DOCUMENT.
DIESE ZEICHNUNG IST EIN KONTROLLIERTES DOKUMENT.

DIMENSIONS:
MASSEINHEITEN:
(MM)

TOLERANCES UNLESS
OTHERWISE SPECIFIED:
ALLGEMEINTOLERANZEN

0 PLC	±
1 PLC	±
2 PLC	±
3 PLC	±
4 PLC	±

ANGLES/WINKEL ±

FINISH/OBERFLÄCHE/FARBE
SEE TABLE
siehe Tabelle

DWN
C. Schnepfer
26 JUL 2018

CHK
J. Barth
27 JUL 2018

APVD
Ch. Eberwein
27 JUL 2018

PRODUCT SPEC
108-94752

APPLICATION SPEC
114-94625

WEIGHT
0.2g

CUSTOMER DRAWING

TE Connectivity

NAME
HD MATenet 1+6 SWS. GRP D
HD MATenet 1+6 EDS. GRP D

SIZE
A2

CAGE CODE
100779

DRAWING NO.
ZEICHNUNGS-NR.
9-2334941

RESTRICTED TO
NUR FÜR
-

SCALE
MASSSTAB
10:1

SHEET
BLATT
1 OF 1

REV
A2