

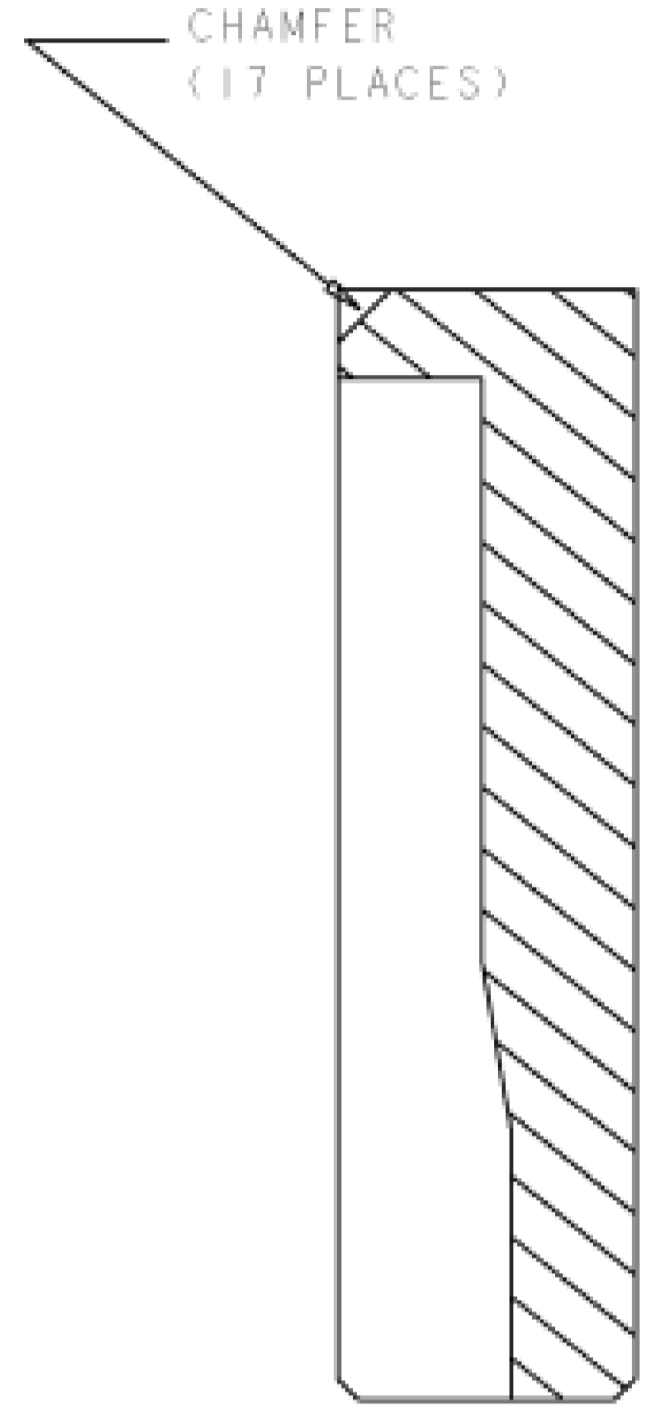
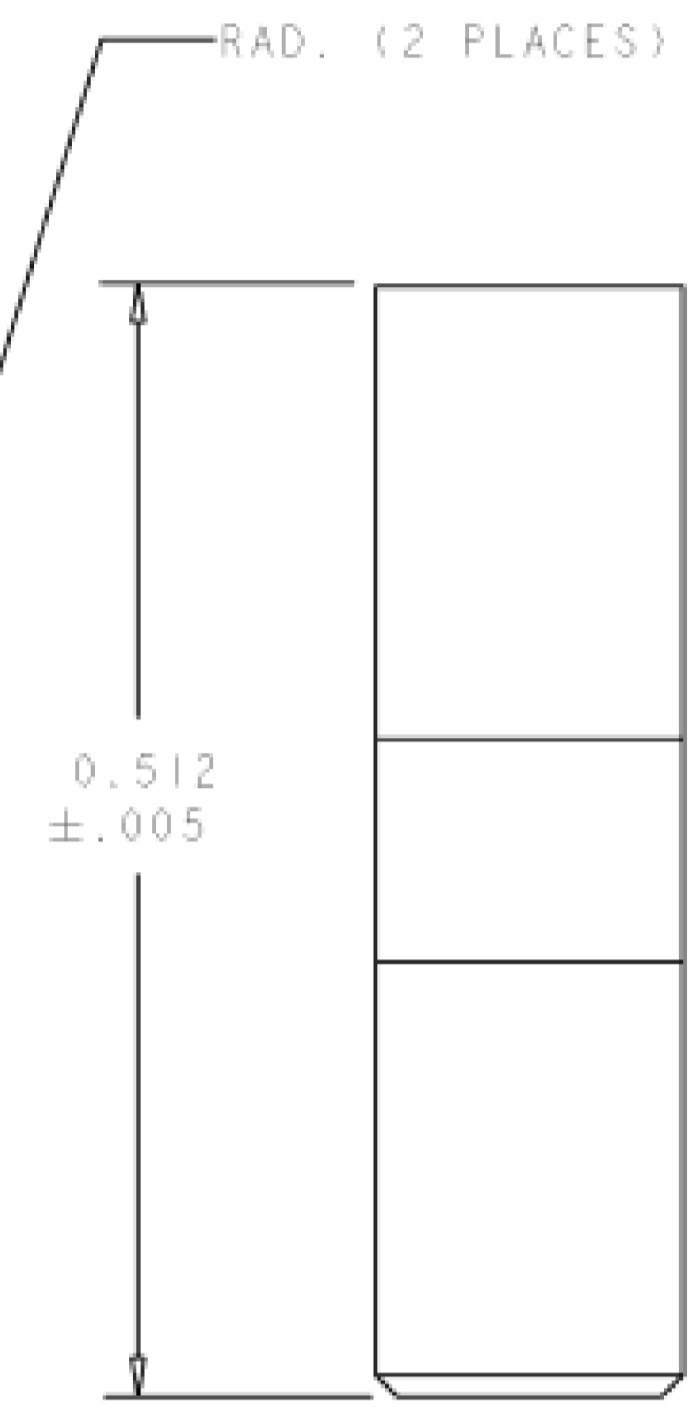
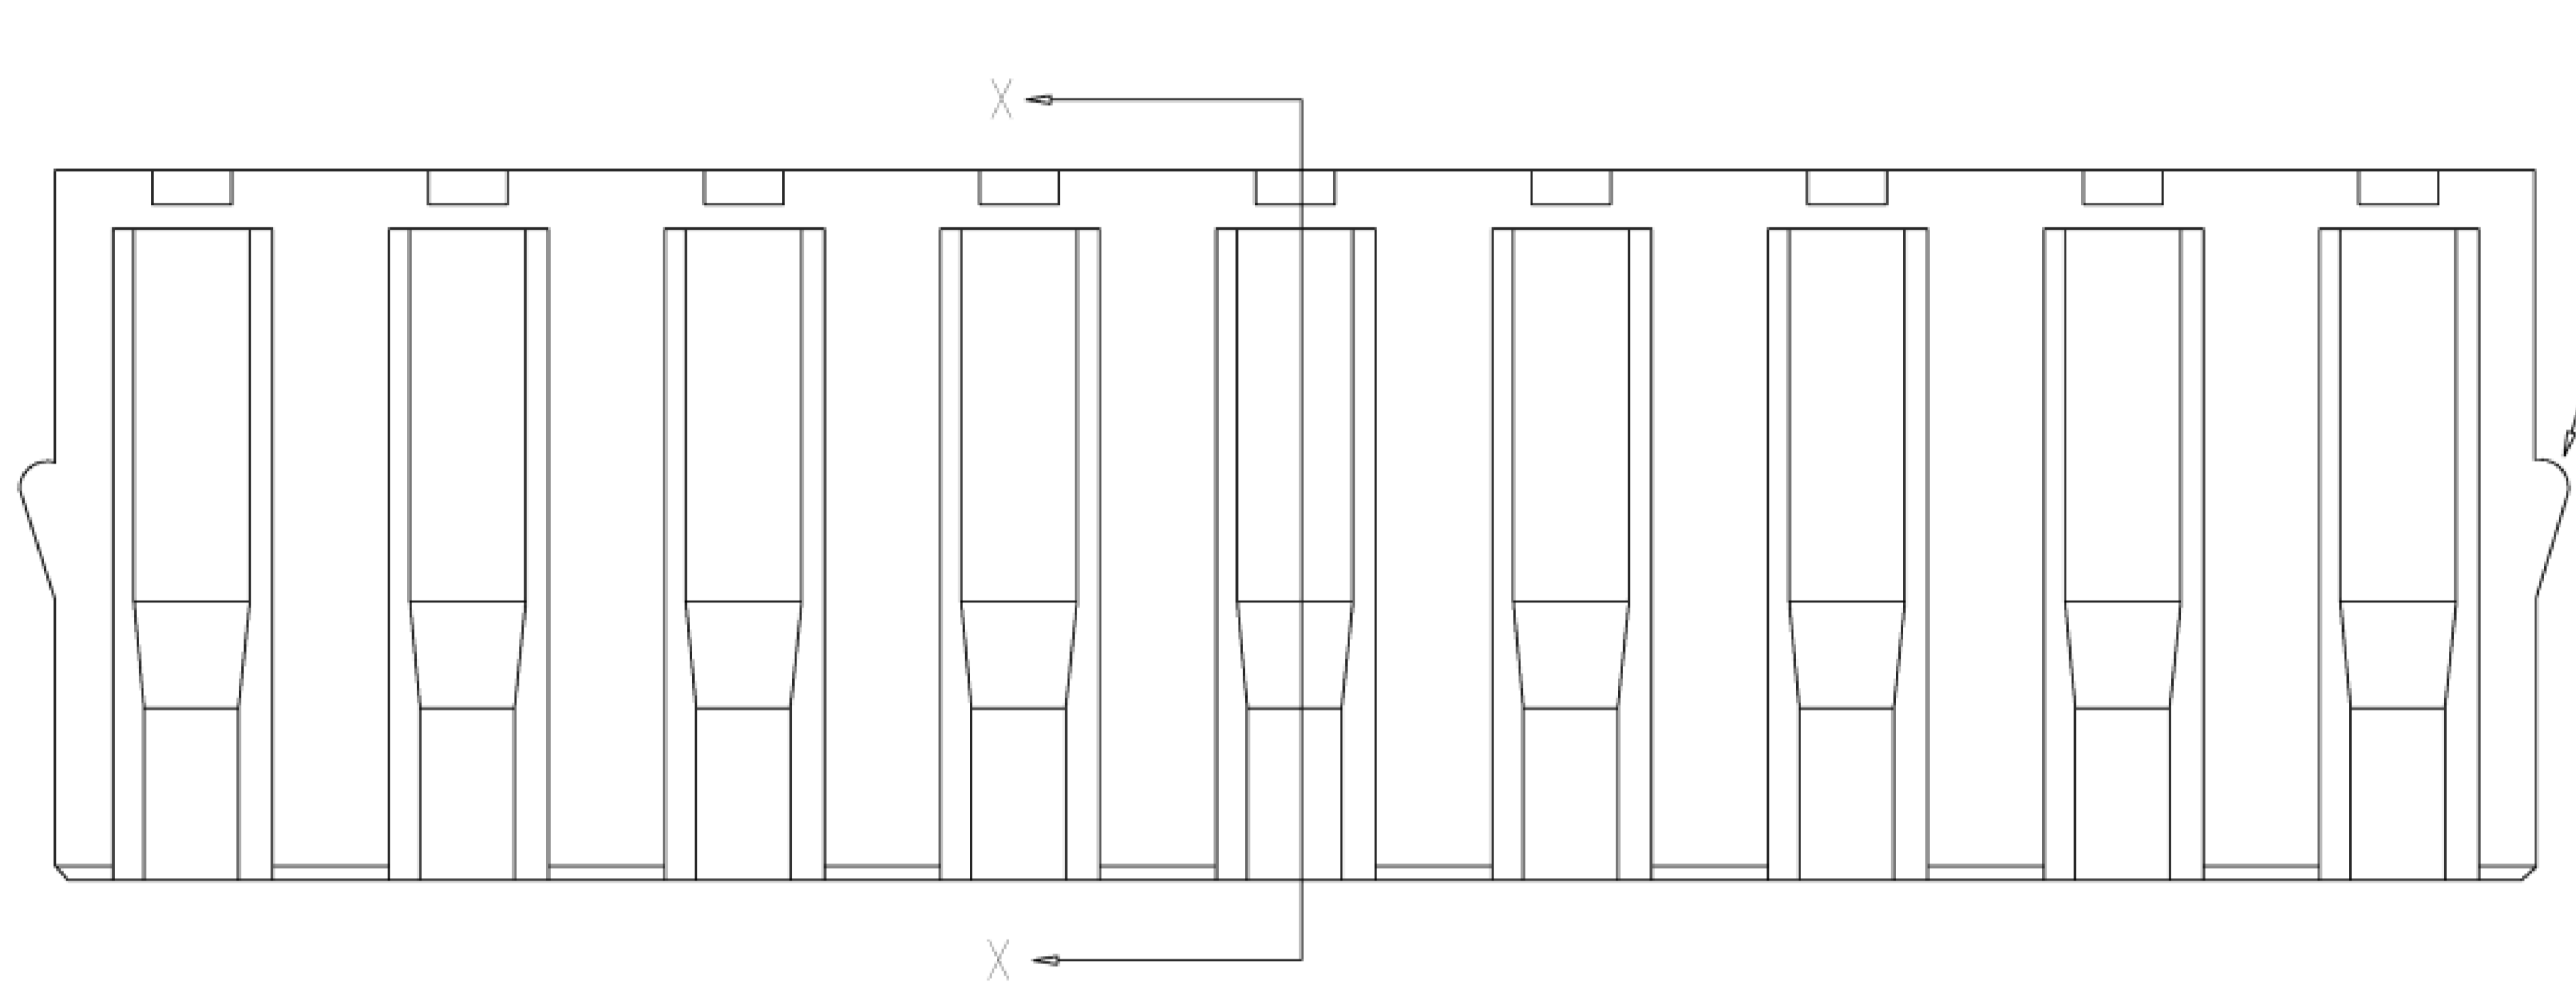


REVISIONS					
P	LTR	DESCRIPTION	DATE	DMN	APVD
A1		OBSOLETE 5-8	ECR-20-002024	28OCT2020	PSJ TM

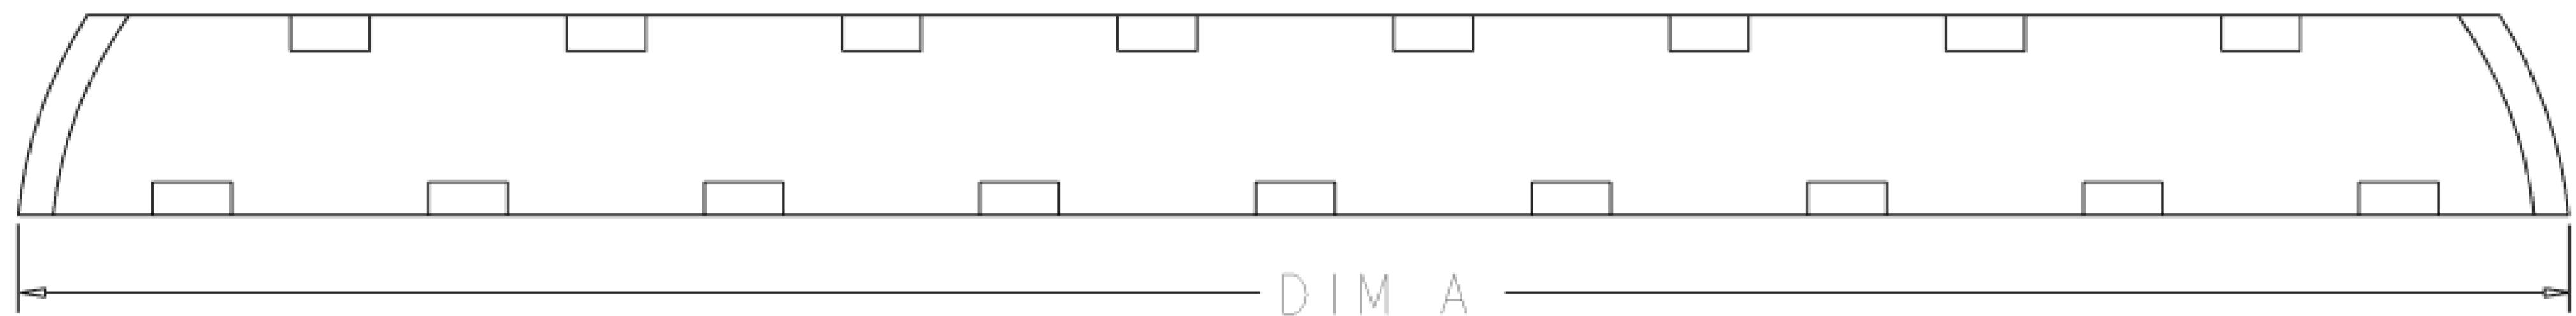

SECTION X-X

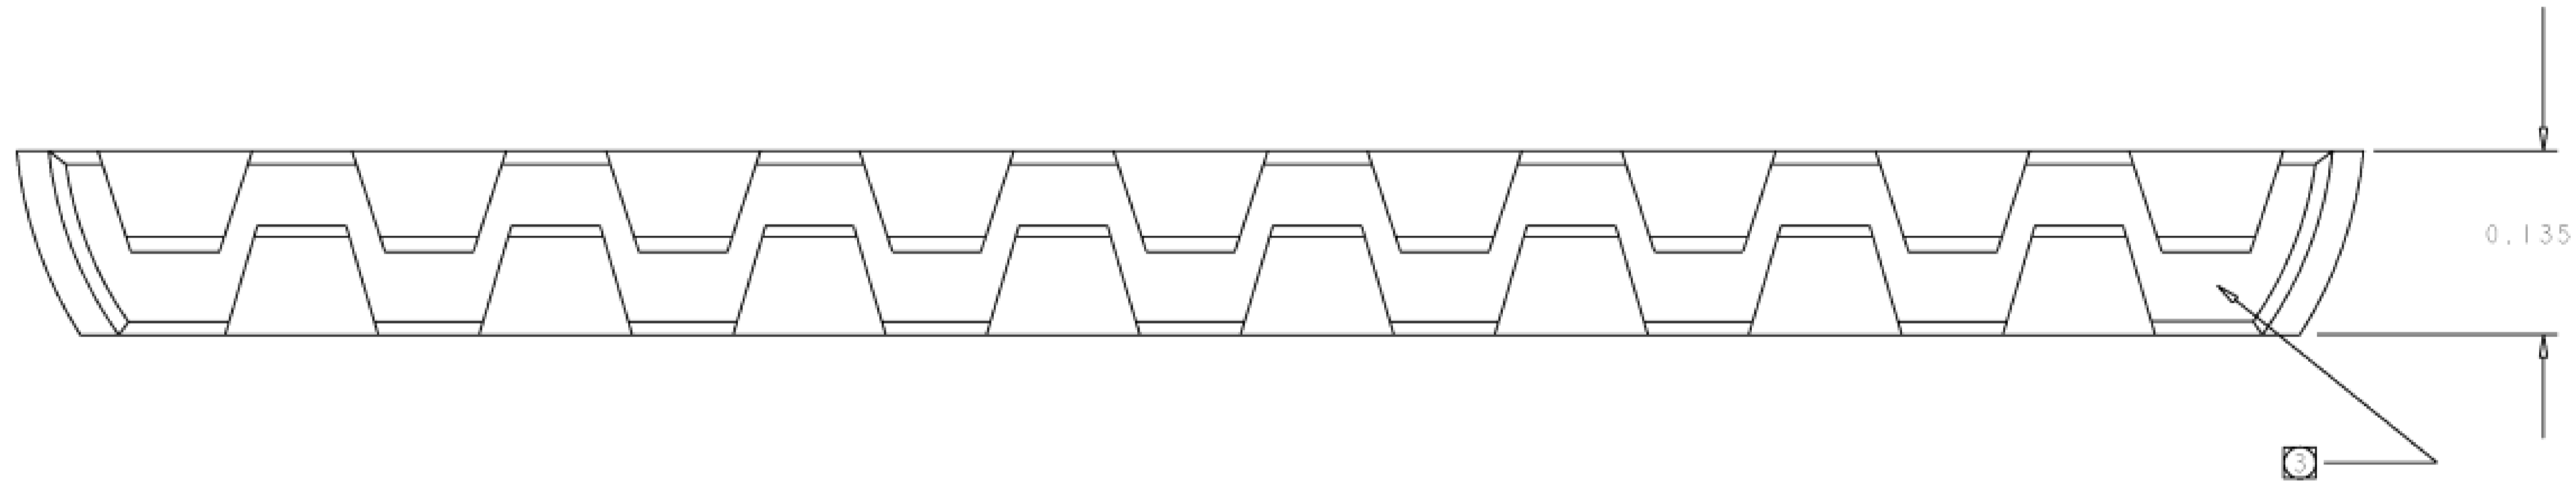

OBSOLETE

CUSTOMER P/N	TYCO P/N	T&B PART NO.	NO. OF POS.	DIM A
<del>29503056</del>	<del>5-1437292-8</del>	<del>6D729-01</del>	<del>5</del>	<del>0.62</del>
	--	6D729-02	7	
	--	6D729-03	9	
	--	6D729-04	11	
	--	6D729-05	13	
	--	6D729-06	15	
29503057	5-1437292-9	6D729-07	17	1.82

- 4. MOLD PER TYCO SPEC. 115-40-2
  - 3. CAVITY I.D. NO. LOCATED AS SHOWN
  - 2. INTERPRET DRAWING PER ANSI-14.5.
  - 1. MATERIAL: 420-SEO VALOX ,BLUE
- NOTES: UNLESS OTHERWISE SPECIFIED  
NOT TO SCALE

THIS DRAWING IS A CONTROLLED DOCUMENT.

DIMENSIONS: INCHES	TOLERANCES UNLESS OTHERWISE SPECIFIED: 0. PLC ± 0.05 1. PLC ± 0.05 2. PLC ± 0.005 3. PLC ± 0.005 4. PLC ± 0.005 ANGLES ± 7	DMN: R. PETROSKIE 23MAR2006 CHK: R. PETROSKIE 23MAR2006 APVD: R. PETROSKIE 23MAR2006	NAME: LOCKING BAR, ATEC
MATERIAL: SEE NOTES	FINISH: -	WEIGHT: 0	RESTRICTED TO: -
CUSTOMER DRAWING		SIZE: A1 CAGE CODE: 00779 DRAWING NO: 6-1437292-8	SCALE: 1:1 SHEET: 1 OF 1 REV: A1