THIS DRAWING IS UNPUBLISHED. RELEASED FOR PUBLICATION , .
© COPYRIGHT 1997 By – ALL RIGHTS RESERVED.

LOC	DIST
J	

REVISIONS 変更

P	LTR	DESCRIPTION	DATE	DWN	APVD
	A	REVISED PER ECR-12-005241	28JUN2012	H.T	J.T

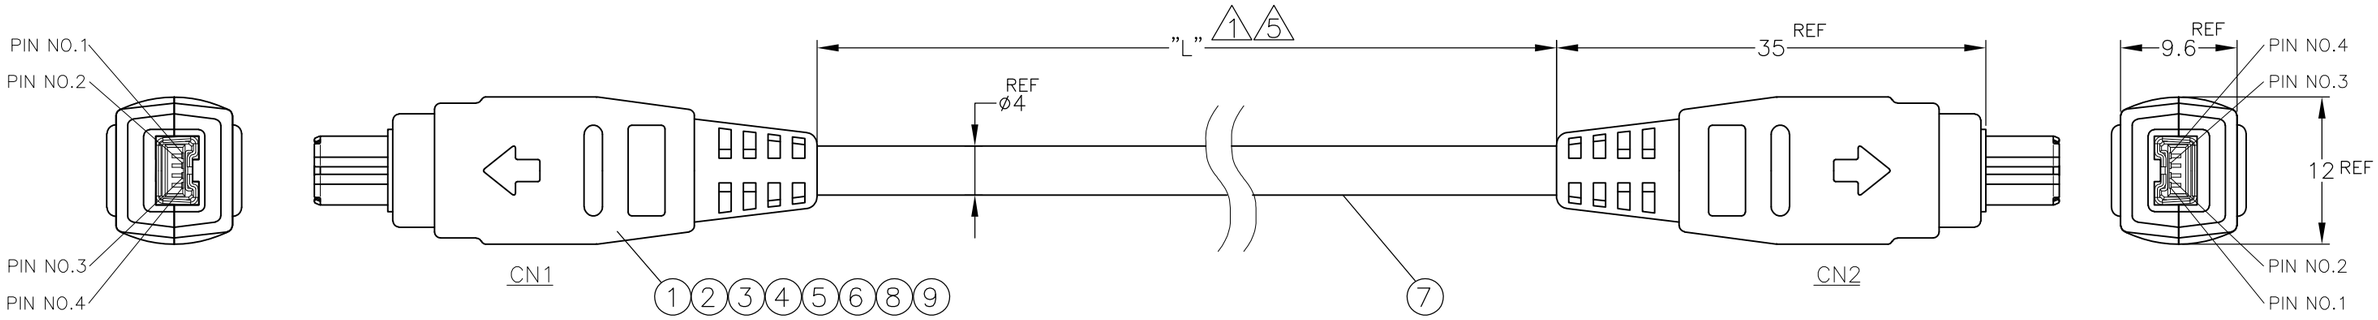

CN1 PIN No.		CN2 PIN No.	CABLE COLOR
1		3	01 RED
2		4	01 GREEN
3		1	BLUE
4		2	ORANGE

3 CONNECTION TABLE

	NET WEIGHT (g)	CABLE LENGTH "L"(mm)	PART NO.	NET WEIGHT (g)	CABLE LENGTH "L"(mm)	PART NO.	
				126.3	5000	~~5-1123076-0~~	6
6	228.0	9500	~~9-1123076-5~~	115.0	4500	~~4-1123076-5~~	6
6	216.7	9000	~~9-1123076-0~~	103.7	4000	4-1123076-0	
6	205.4	8500	~~8-1123076-5~~	92.4	3500	~~3-1123076-5~~	6
6	194.1	8000	~~8-1123076-0~~	81.1	3000	~~3-1123076-0~~	6
6	182.8	7500	~~7-1123076-5~~	69.8	2500	~~2-1123076-5~~	6
6	171.5	7000	~~7-1123076-0~~	58.5	2000	~~2-1123076-0~~	6
6	160.2	6500	~~6-1123076-5~~	47.2	1500	~~1-1123076-5~~	6
6	148.9	6000	~~6-1123076-0~~	35.9	1000	~~1-1123076-0~~	6
6	137.6	5500	~~5-1123076-5~~	24.6	500	~~1123076-5~~	6

1 5 TABLE[1]

QTY REQD PER ASSY	NAME	ITEM NO.
AR	INSULATION TAPE	9
AR	COPPER FOIL TAPE	8
1	CABLE: SPEC NO IE6-03048 : SUMITOMO 01	7
2	LOWER COVER FOR IEEE 1394 AV CONN.	6
2	UPPER COVER FOR IEEE 1394 AV CONN.	5
2	BUSHING FOR IEEE 1394 AV CONN.	4
2	SHIELD CASE LOWER FOR IEEE 1394 AV CONN.	3
2	SHIELD CASE UPPER FOR IEEE 1394 AV CONN.	2
2	SUB ASSY FOR IEEE 1394 AV CONN.	1

PARTS LIST

LEAD FREE

NOTE
1 [TABLE1] INDICATES THE RELATION BETWEEN P/N AND CABLE LENGTH "L"
2.CONNECTOR DIMENSIONS : REF DWG NO.353455.
3 CONDUCTIVE INSPECTION (SHORT, SNAPPING OF WIRE, ERR WIRING)
4.DIELECTRIC WITHSTANDING VOLTAGE TEST:
AC350V, 0.5sec.,1mA MAX. (BETWEEN ODD AND EVEN UMBER OF PIN)
AC500V, 0.5sec.,1mA MAX. (BETWEEN SHIELD AND PIN)
5 TOLERANCE AFTER CABLE ASSEMBLY.
L= 500~5000mm:-0~+100
L=5500~9500mm:-0~+200
6 OBSOLETE

THIS DRAWING IS A CONTROLLED DOCUMENT.

DIMENSIONS: 単位： 粍 mm

TOLERANCES UNLESS OTHERWISE SPECIFIED: 一般公差
0 PLC ±
1 PLC ±
2 PLC ±
3 PLC ±
4 PLC ±
ANGLES ±

MATERIAL 材料
FINISH 仕上

DWN	N.OHTSU	25AUG97
CHK	H.SHOJI	25AUG97
APVD	K.TAKAHASHI	25AUG97
PRODUCT SPEC 製品規格	—	
APPLICATION SPEC 取付適用規格	—	
WEIGHT	SEE TABLE [1]	

TE Connectivity

NAME 名称: IEEE 1394 CABLE ASS'Y

SIZE	CAGE CODE	DRAWING NO 番号	RESTRICTED TO
A3	00779	C-1123076	–

CUSTOMER DRAWING | SCALE 尺度 2:1 | SHEET 1 OF 1 | REV A